


OPEN HUNGRY BOARDS

REAR CAB WALL

TENDER SIDES

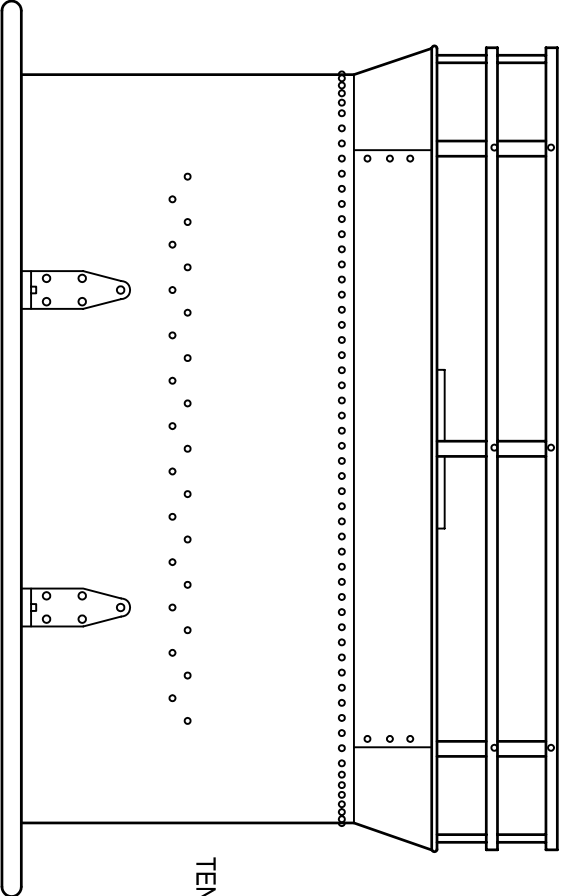

TENDER REAR

OVERALL TENDER VIEW
AS BUILT – SHORT TENDER

